



ARCHITECTURE \ INTERIORS \ ENGINEERING


KKT ARCHITECTS, INC.
2200 SOUTH UTICA PLACE, SUITE 200
TULSA, OKLAHOMA 74114
[P] 918.744.4270 \ [F] 918.744.7849
WWW.KKTARCHITECTS.COM
C O F A # 534 6/30/21

SUITE 100

SUITE 1170
VACANT
1458 RSF

SUITE 1180

SUITE 1190

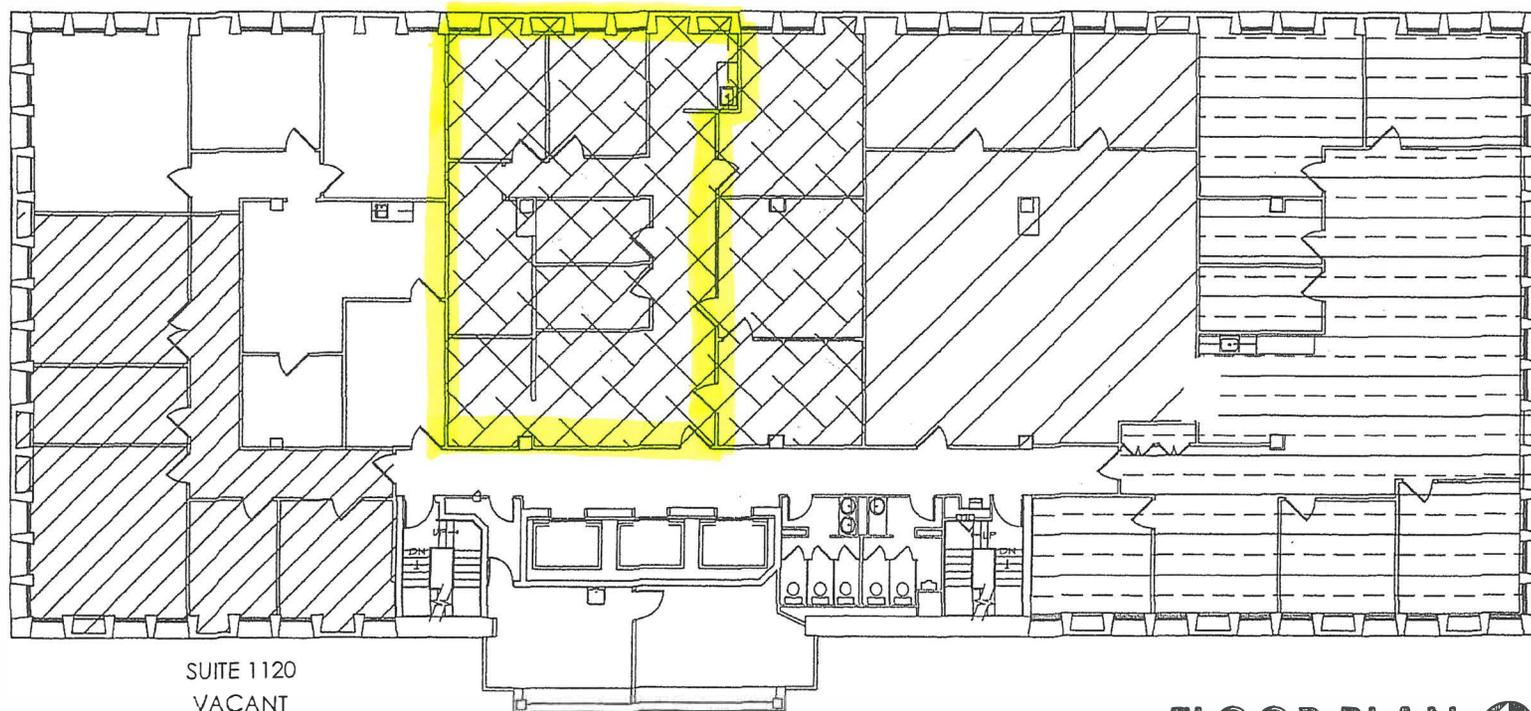

SUITE 1120
VACANT
1441 RSF

A FLOOR PLAN 
SCALE: N.T.S. NORTH

**11TH
FLOOR**

SOUTHLAND
TOWER
11TH FLOOR

PRICE
EDWARDS
AND COMPANY

03.05.2021



AS-BUILT
PLAN

AS.11