


SUITE 400

5,488 RSF

SUITE 450
 AVAILABLE
 4710.89 RSF

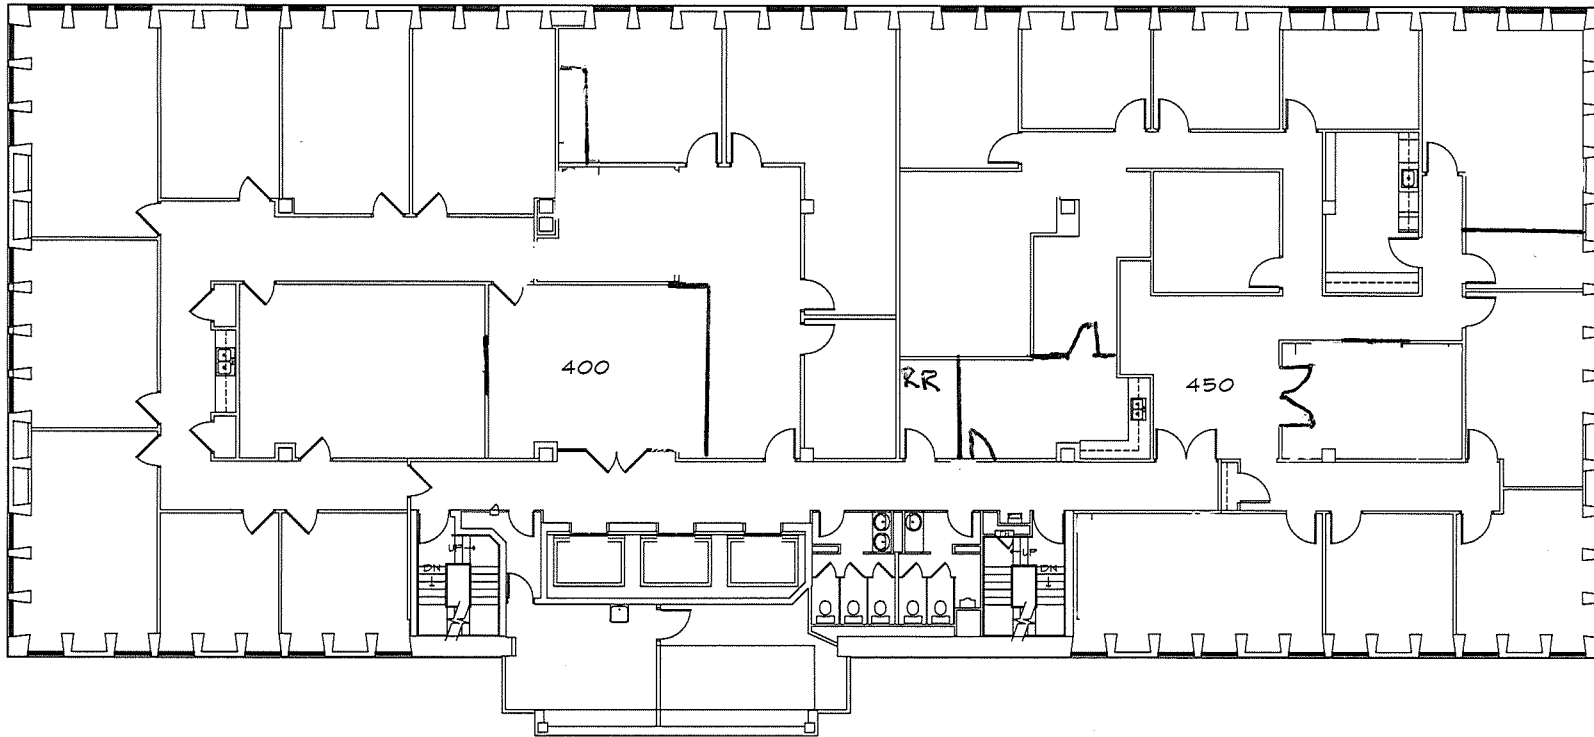

**4TH FLOOR
 PLAN**

SOUTHLAND
 TOWER
 4TH FLOOR



10.25.2019



A FLOOR PLAN 
 SCALE: N.T.S. NORTH

AS-BUILT
 PLAN
AS.4